



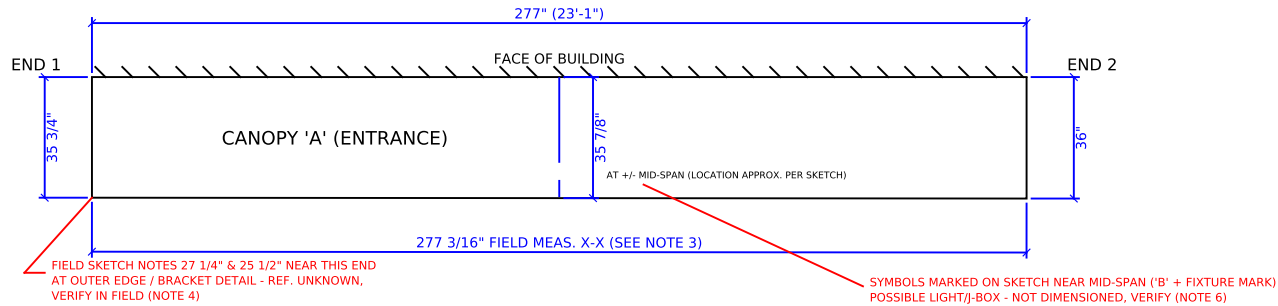

GENERAL NOTES

1. ALL DIMENSIONS ARE FIELD-MEASURED AS-BUILT CONDITIONS TAKEN 8/31/26.
DRAWING IS TRUE SCALE, 1 DRAWING UNIT = 1 INCH.
2. CANOPY A IS NOT SQUARE. PROJECTION FROM BUILDING FACE GROWS UNIFORMLY FROM 35 3/4" AT END 1 TO 36" AT END 2 (+1/4" OVER 23'-1"). MID-SPAN MEASUREMENT OF 35 7/8" MATCHES STRAIGHT-LINE INTERPOLATION: FASCIA IS STRAIGHT (NOT BOWED), UNIFORMLY OUT OF PARALLEL WITH BUILDING FACE.
3. OUTER (FASCIA) EDGE FIELD-MEASURED 277 3/16" X-TO-X, 3/16" LONGER THAN BUILDING-FACE LENGTH (277"). CORNER-TO-CORNER LENGTH COMPUTED FROM PERPENDICULAR PROJECTIONS IS +/-277": DIFFERENCE INDICATES END RETURNS ARE NOT PERPENDICULAR TO BUILDING FACE. PULL BOTH DIAGONALS TO CLOSE THE GEOMETRY BEFORE FABRICATION.
4. FIELD SKETCH NOTES 27 1/4" AND 25 1/2" NEAR END 1 AT THE OUTER EDGE (AT A BRACKET/CLIP DETAIL). REFERENCE POINT NOT IDENTIFIED ON SKETCH. VERIFY IN FIELD BEFORE USE.
5. DO NOT FABRICATE FRAMING SQUARE. CUT OUTLOOKERS / RAFTERS TO RUN - LENGTHS VARY 35 3/4" TO 36" ALONG THE 277" RUN. FIELD-MEASURE EACH END CLOSURE INDIVIDUALLY.
6. SYMBOLS ON SKETCH NEAR MID-SPAN ('B' + FIXTURE MARK) ARE NOT DIMENSIONED - POSSIBLE LIGHT FIXTURE / J-BOX. VERIFY.
7. END 1 / END 2 DESIGNATIONS FOLLOW FIELD SKETCH ORIENTATION ONLY - CONFIRM AGAINST SITE ORIENTATION BEFORE LAYOUT.

SKEW DIAGRAM - EXAGGERATED, N.T.S.

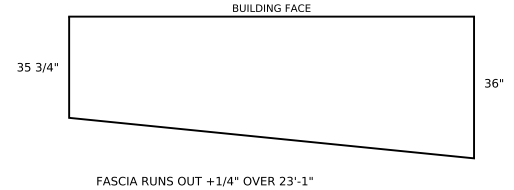

LEE STREET - CANOPY 'A' (ENTRANCE) - AS-BUILT FRAMING PLAN

AS-BUILT FIELD MEASUREMENTS 8/31/2026 | EXISTING CONDITIONS - NOT SQUARE, SEE NOTES | UNITS: INCHES (TRUE SCALE)